



**BIODIVERSITY NET GAIN – RIVER METRIC process – step by step flow chart exercise**


**P 1 - PRELIMINARY INFORMATION & INVESTIGATIONS – What's the bigger picture...?**

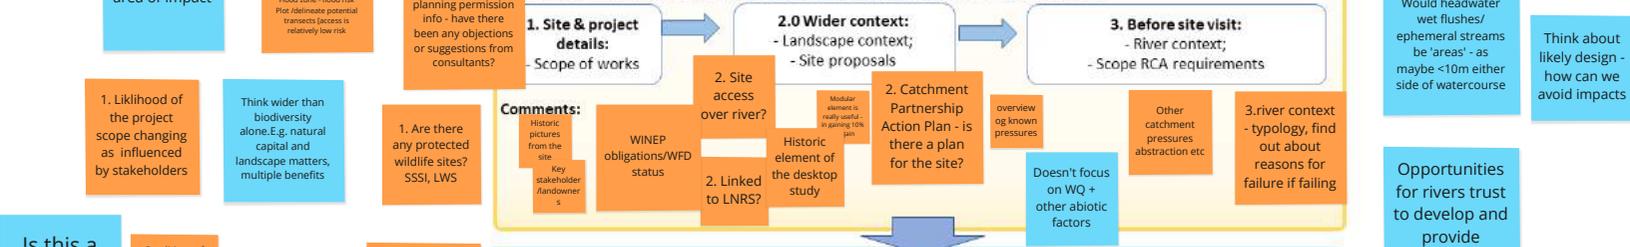


**STEP 2 - RIVER CONDITION INVESTIGATIONS – What's needed to assess, understand and improve your River Condition..?**

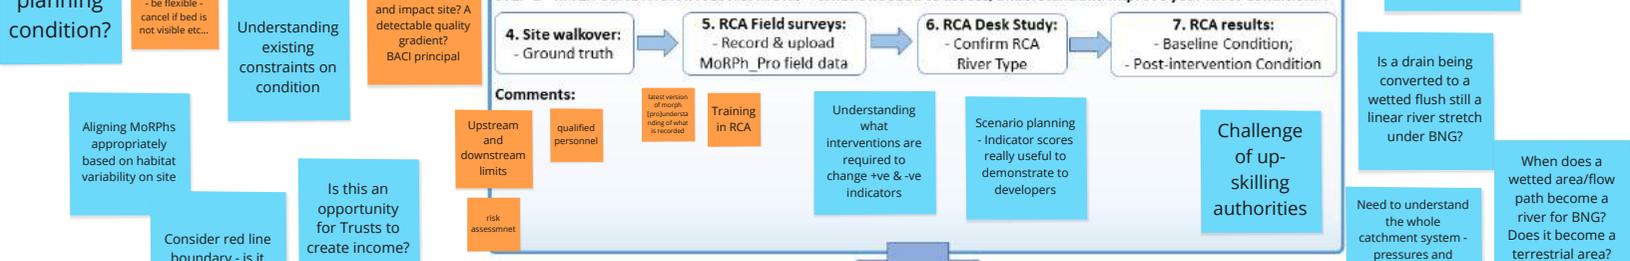

**STEP 3 - BM3.0 tool: RIVER METRIC ASSESSMENT (ON SITE) – What's needed to calculate River Metric Units & Net Gain?**

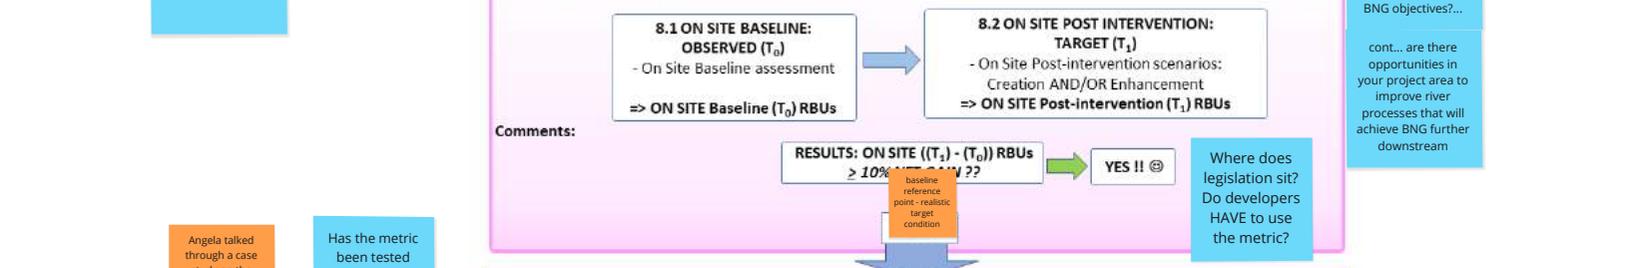


**STEP 4 - BM3.0 tool: RIVER METRIC ASSESSMENT (OFF SITE) – What's needed if on site River Metric Net Gain is < 10%?**

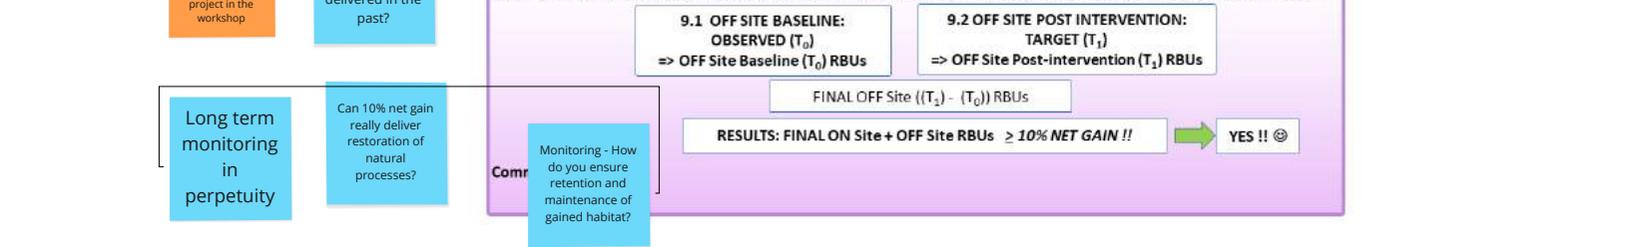


# BIODIVERSITY NET GAIN – RIVER METRIC process – supplementary information


## STEP 1 - PRELIMINARY INFORMATION & INVESTIGATIONS (PRE-SITE VISIT) – What's the bigger picture...?

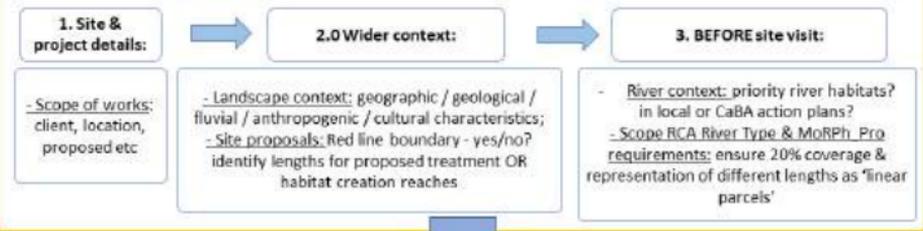

## STEP 2 - RIVER CONDITION INVESTIGATIONS – What's needed to assess, understand and improve your River Condition..?

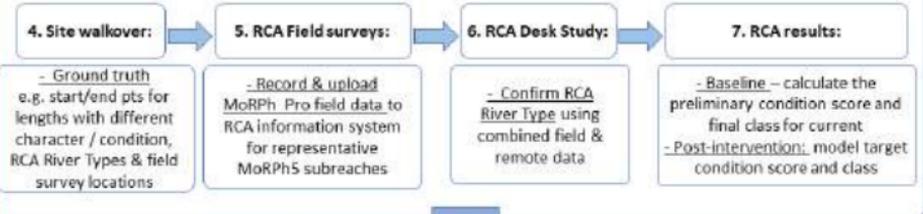

## STEP 3 - BM3.0 tool: RIVER METRIC ASSESSMENT (ON SITE) - What's needed to calculate River Metric Units & Net Gain?

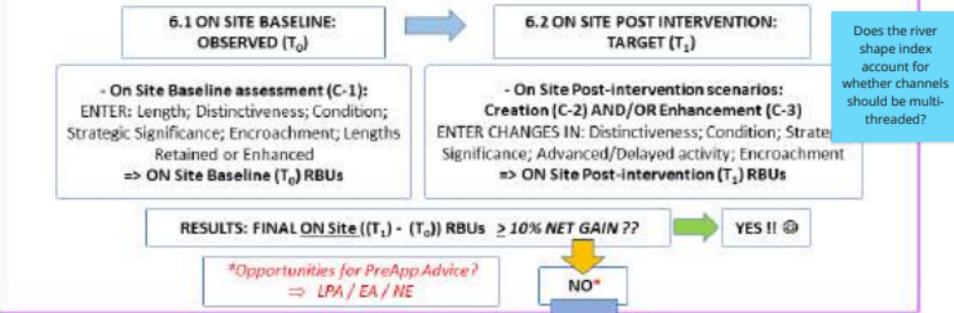

## STEP 4 - BM3.0 tool: RIVER METRIC ASSESSMENT (OFF SITE\*)



### TO FIND OUT MORE:

The Biodiversity Metric 3.0 guidance: <http://nepubprod.appspot.com/publication/6049804846364720>

River Condition Assessment Guidance & Training: <https://modularriversurvey.org/river-condition/>

CIEEM BNG Guidance & River Metric Training\*: <https://cieem.net/j-am/current-projects/biodiversity-net-gain/>

\* Search for 'CIEEM + River Metric' for event waiting list

## Red Stream



- No artificial/managed bank top
- Steep banks
- No bank or bed reinforcement
- Natural bank top and bank face vegetation, including trees
- Invasive species
- Smooth flow
- No in-channel features visible
- Floating vegetation
- Overhanging vegetation
- Some shading
- Fallen trees

Wider channel,  
improve  
planform,  
introduce  
gravels

since banks are not reinforced - should be easier to give a natural profile as part of programme of measures

more LWD for more in channel features and flow heterogeneity, also refugia for fish



Condition: Moderate

invasive species removal programme or fund existing work

create in-channel features

berms and gravel seeding to have more flow heterogeneity

fallen trees give this site some more value than Old Brook site

regrade banks so there is more heterogeneity and wet margins

more natural bank profiles

Large wood, riparian planting, marginal scrapes

# Old Brook



- Managed bank top
- Reshaped bank face
- No bank or bed reinforcement
- Limited natural bank top and bank face vegetation, some trees
- Invasive species
- Smooth flow
- No in-channel features visible
- Overhanging vegetation
- Shading

full 10% less likely to be reached

install woody features

Selective daylighting and wood placement

invasive sp removal programme

Condition: Fairly Poor



Add in-channel features

selective clearance of overhanging vegetation - to get a mixture of shaded and sunlit stretches [check for bat roosts etc beforehand]

2 stage channel for old brook

Create bank top buffer zone.

assess type of banktop management and draw up alternative, low maintenance management scheme to benefit riparian species

Monitoring and maintenance tracking

Raise bed level

Re-profile one bank

Realign?



You could theoretically degrade 1 WFD water body and put all mitigation on another


Does BNG trump WFD?

Old Brook

Red Stream

Re-align the planned route of the road so that it crosses the river perpendicular to the river. This will reduce the length of its impact.

- Rivers
- Existing Road
- Red Line Boundary
- Proposed Realignment
- Proposed Road

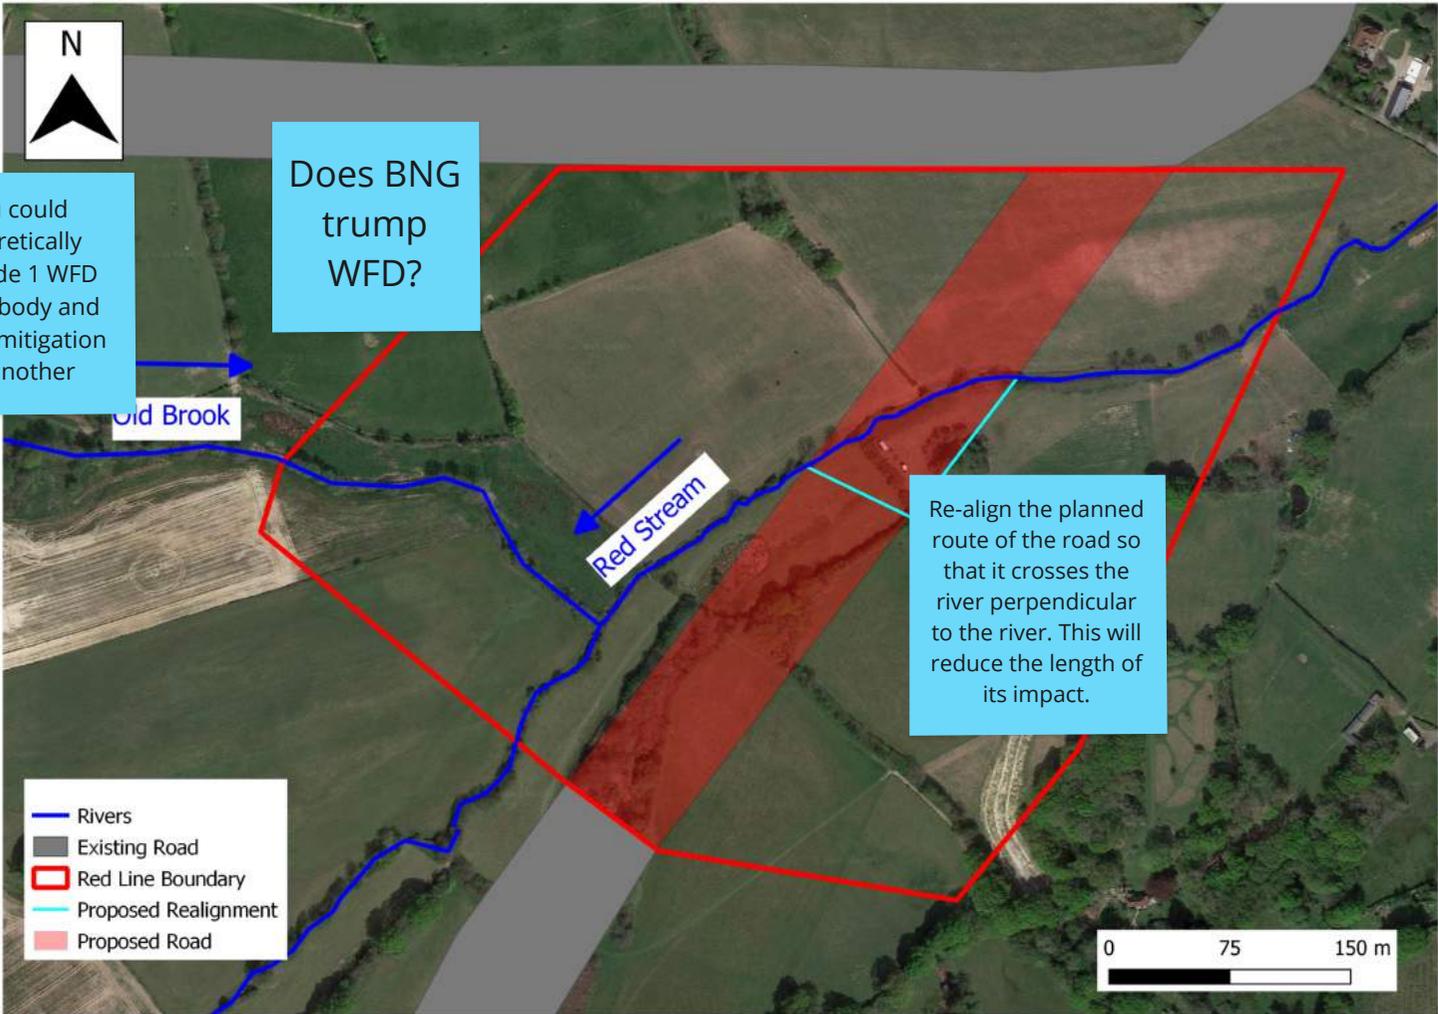

You need more vegetation, more shade to the water, add meanders.

Bridge for the road?.. or maybe a culvert under the red stream for the road?

The Red Stream diversion needs to be more diverse in terms of geomorphology and habitat, e.g. add meanders, more in-stream features, backwaters, ponds, native tree planting

Remeander section of Red Brook

Build viaduct over river

Sediment management south of Old Brook - riparian buffer (native species)?

Location of red line boundary is crucial

## Question 1: What are you going to do?

Realignment of proposed alignment

Alter the proposed Red Stream culvert design to a wide open span bridge, retaining natural banks



Restore Old Brook to its floodplain, including backwaters, ponds, native tree planting

Can the road be elevated above the river so a culvert isn't required. Shading would still be a problem, but less enhancements would be required to mitigate

Can the road go in a tunnel underneath the river retaining the floodplain and river

Concentrate on Old Brook? Fairly poor.

Use local knowledge, existing data u/s and d/s

INNS  
management  
on both  
streams

In stream  
features  
old brook

Wetland  
creation

Question 1: What are you going to do now  
your proposals haven't reached 10% BNG?

Look off site  
for  
enhancements

Plant  
trees

Floodplain  
reconnection  
old brook